


# MICE HALL TRAYWORK/TRUNKING PLAN VIEW

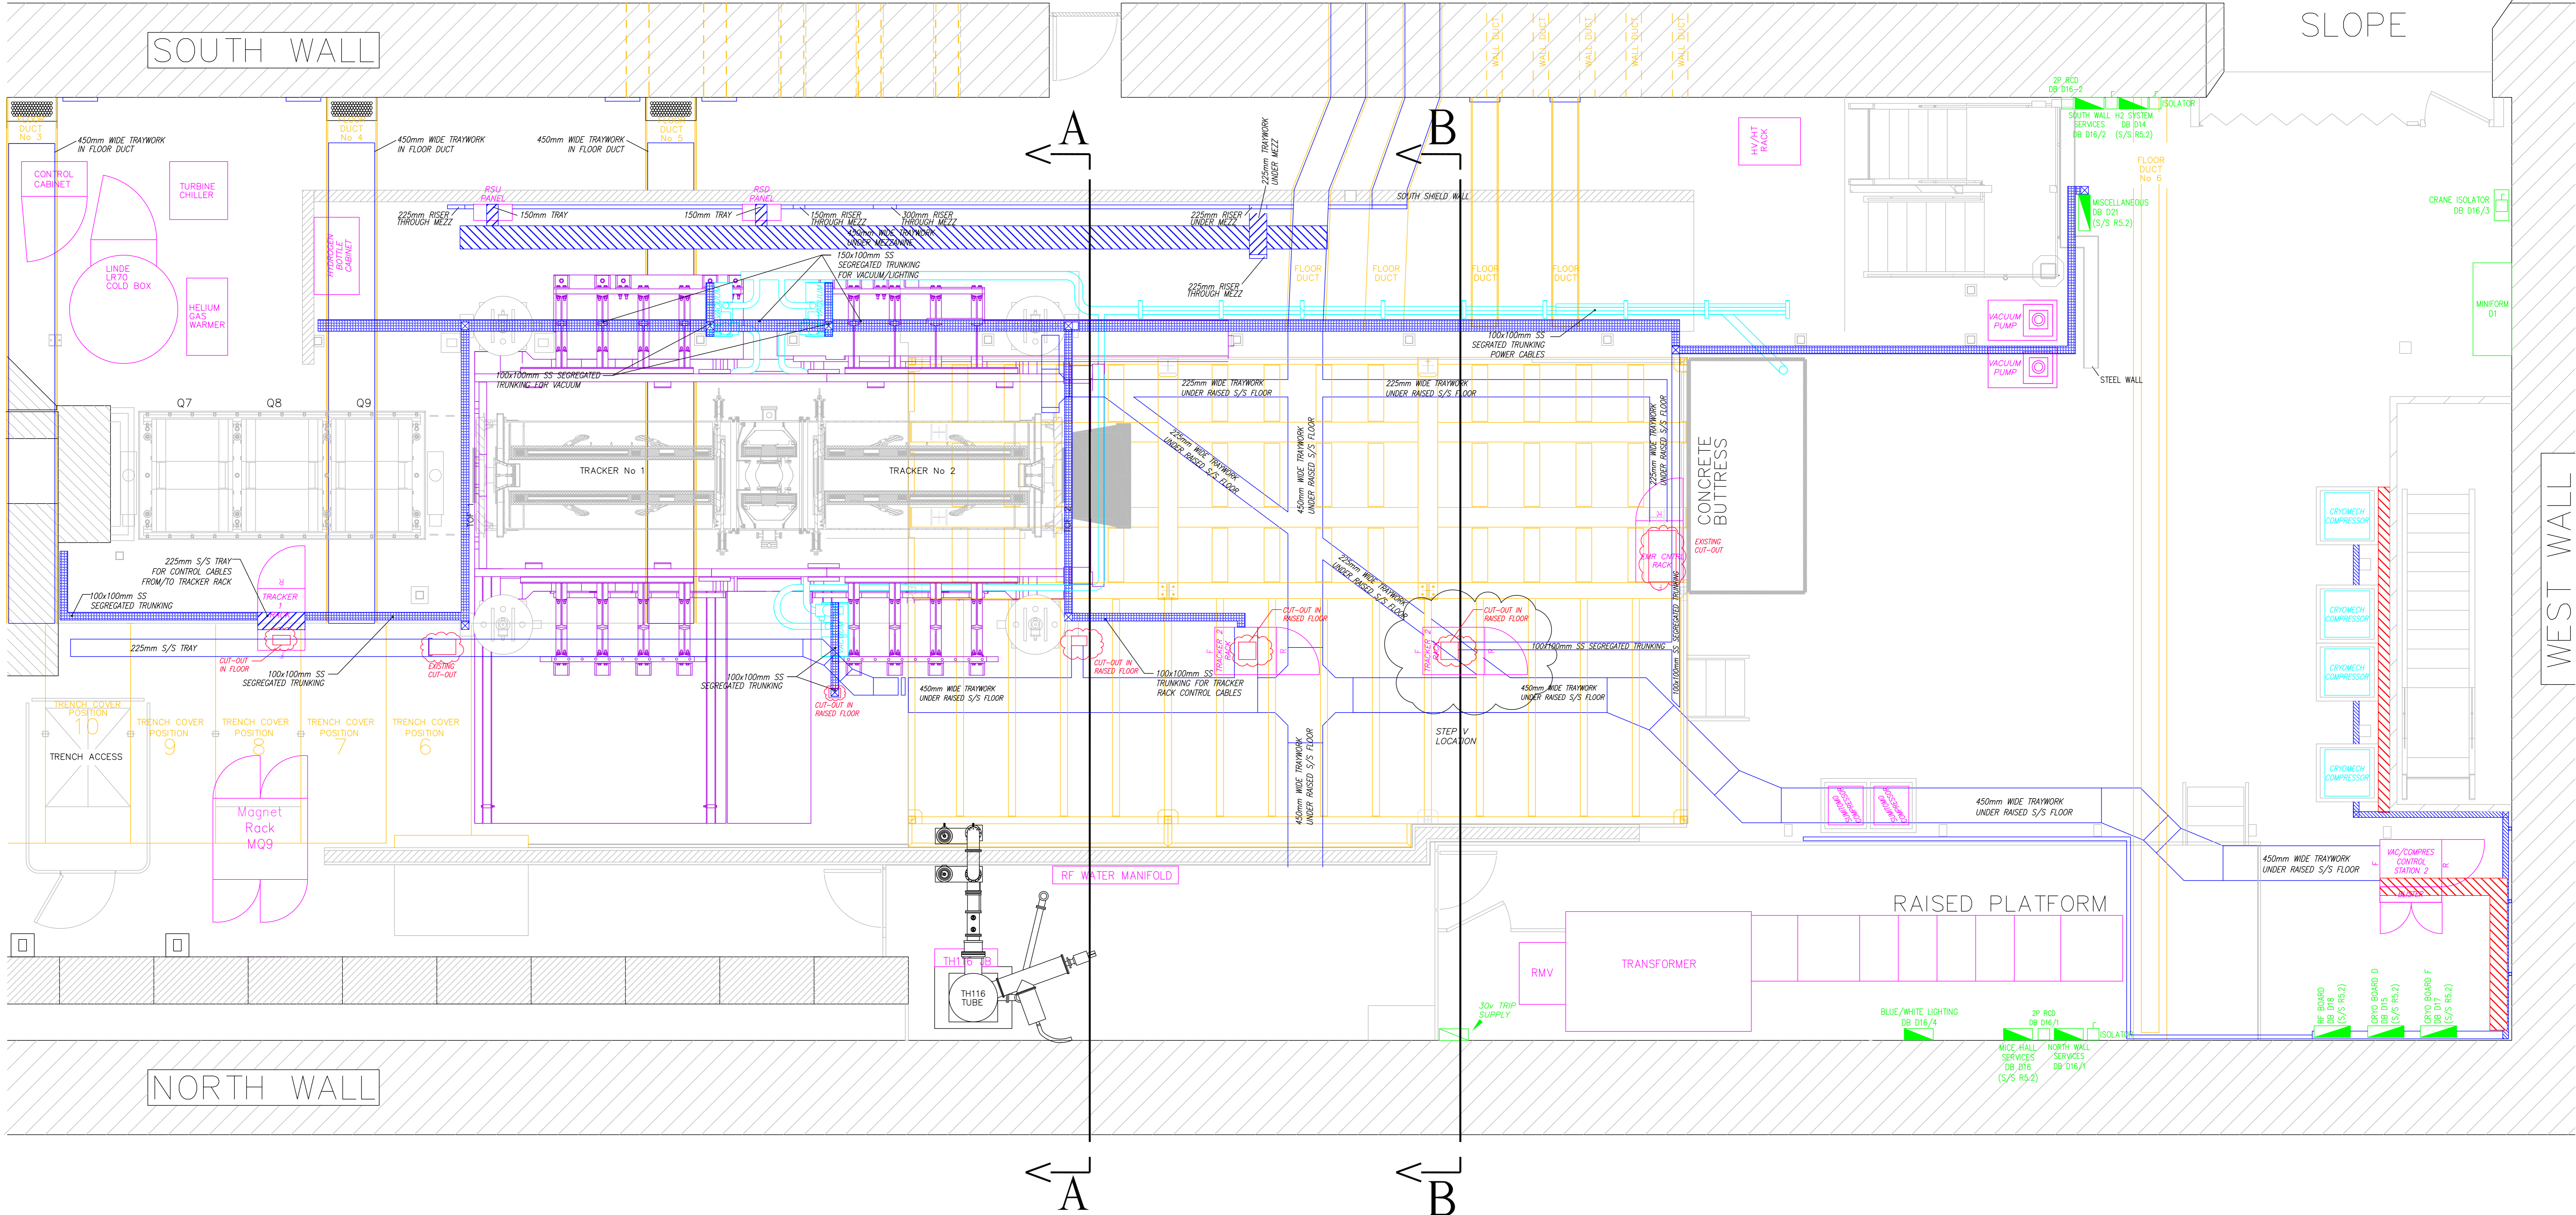

## KEY

- TRAY/TRUNKING INSTALLED UNDER RAISED FLOOR
- NOTES/COMMENTS
- RAISED FLOOR/FLOOR DUCTS
- TRAY INSTALLED ABOVE RAISED FLOOR
- CONTROL/PSU RACKS
- POWER DISTRIBUTION BOARD
- TRUNKING INSTALLED ABOVE RAISED FLOOR
- PARTIAL RETURN YOKE (PRY)
- CUT OUT IN RAISED FLOOR

FIRST ISSUE	DRN	JWW	DATE	APPD	CKD	DATE
A	JWW	JWW	AUG 14	JWW	JWW	AUG 14
B	JWW	JWW	AUG 14	JWW	JWW	AUG 14
C	JWW	JWW	OCT 2014	JWW	JWW	OCT 2014
D	JWW	JWW	NOV 2014	JWW	JWW	NOV 2014
E	JWW	JWW	NOV 2014	JWW	JWW	NOV 2014

INFRASTRUCTURE MEETING UPDATE: 450 WIDE TRAY MOVED. SUMITOMO COMP'S TRUNKING ROUTES UPDATE.

VISUAL INSPECTION OF MICE HALL: 450 WIDE TRAY MOVED. SUMITOMO COMP'S TRUNKING ROUTES UPDATE.

TRAY/TRUNKING, FLOOR CUT-OUTS AND PANEL LOCATIONS AS INSTALLED

COMPRESSOR HOSE ROUTES UPDATED DUE TO REPOSITIONING OF COMPRESSORS. TRENCH TRAY SIZE CHANGED.

SCALE 1:30

ALL DIMENSIONS IN MILLIMETERS UNLESS OTHERWISE STATED

SCIENCE AND TECHNOLOGY FACILITIES COUNCIL  
DARESURY LABORATORY  
CHESHIRE

DRN JWW DATE MAY 2014

CKD DATE

CERT DATE

APPD DATE

DRG No 204-70025 SH3 OF 13

CAD PART No 204-70025\_3

DRAWING LIST: - 204/70000

CONTRACTORS COMPANY  
CONTRACTORS DRG No

ISSUE E