


ELEVATION - VIEW B-B

- 1) PRY DETAILS REQUIRED TO ENSURE TRUNKING CAN BE MOUNTED ON PRY SUPPORTS WITHOUT COMPROMISING REMOVABLE PLATES OF THE PRY AROUND THE FC MAGNET.
- 2) CHECK THERE ARE NO CLASHES/ISSUES WITH 450mm WIDE TRAY ROUTES REQUIRED FOR POWER/CONTROL CABLES

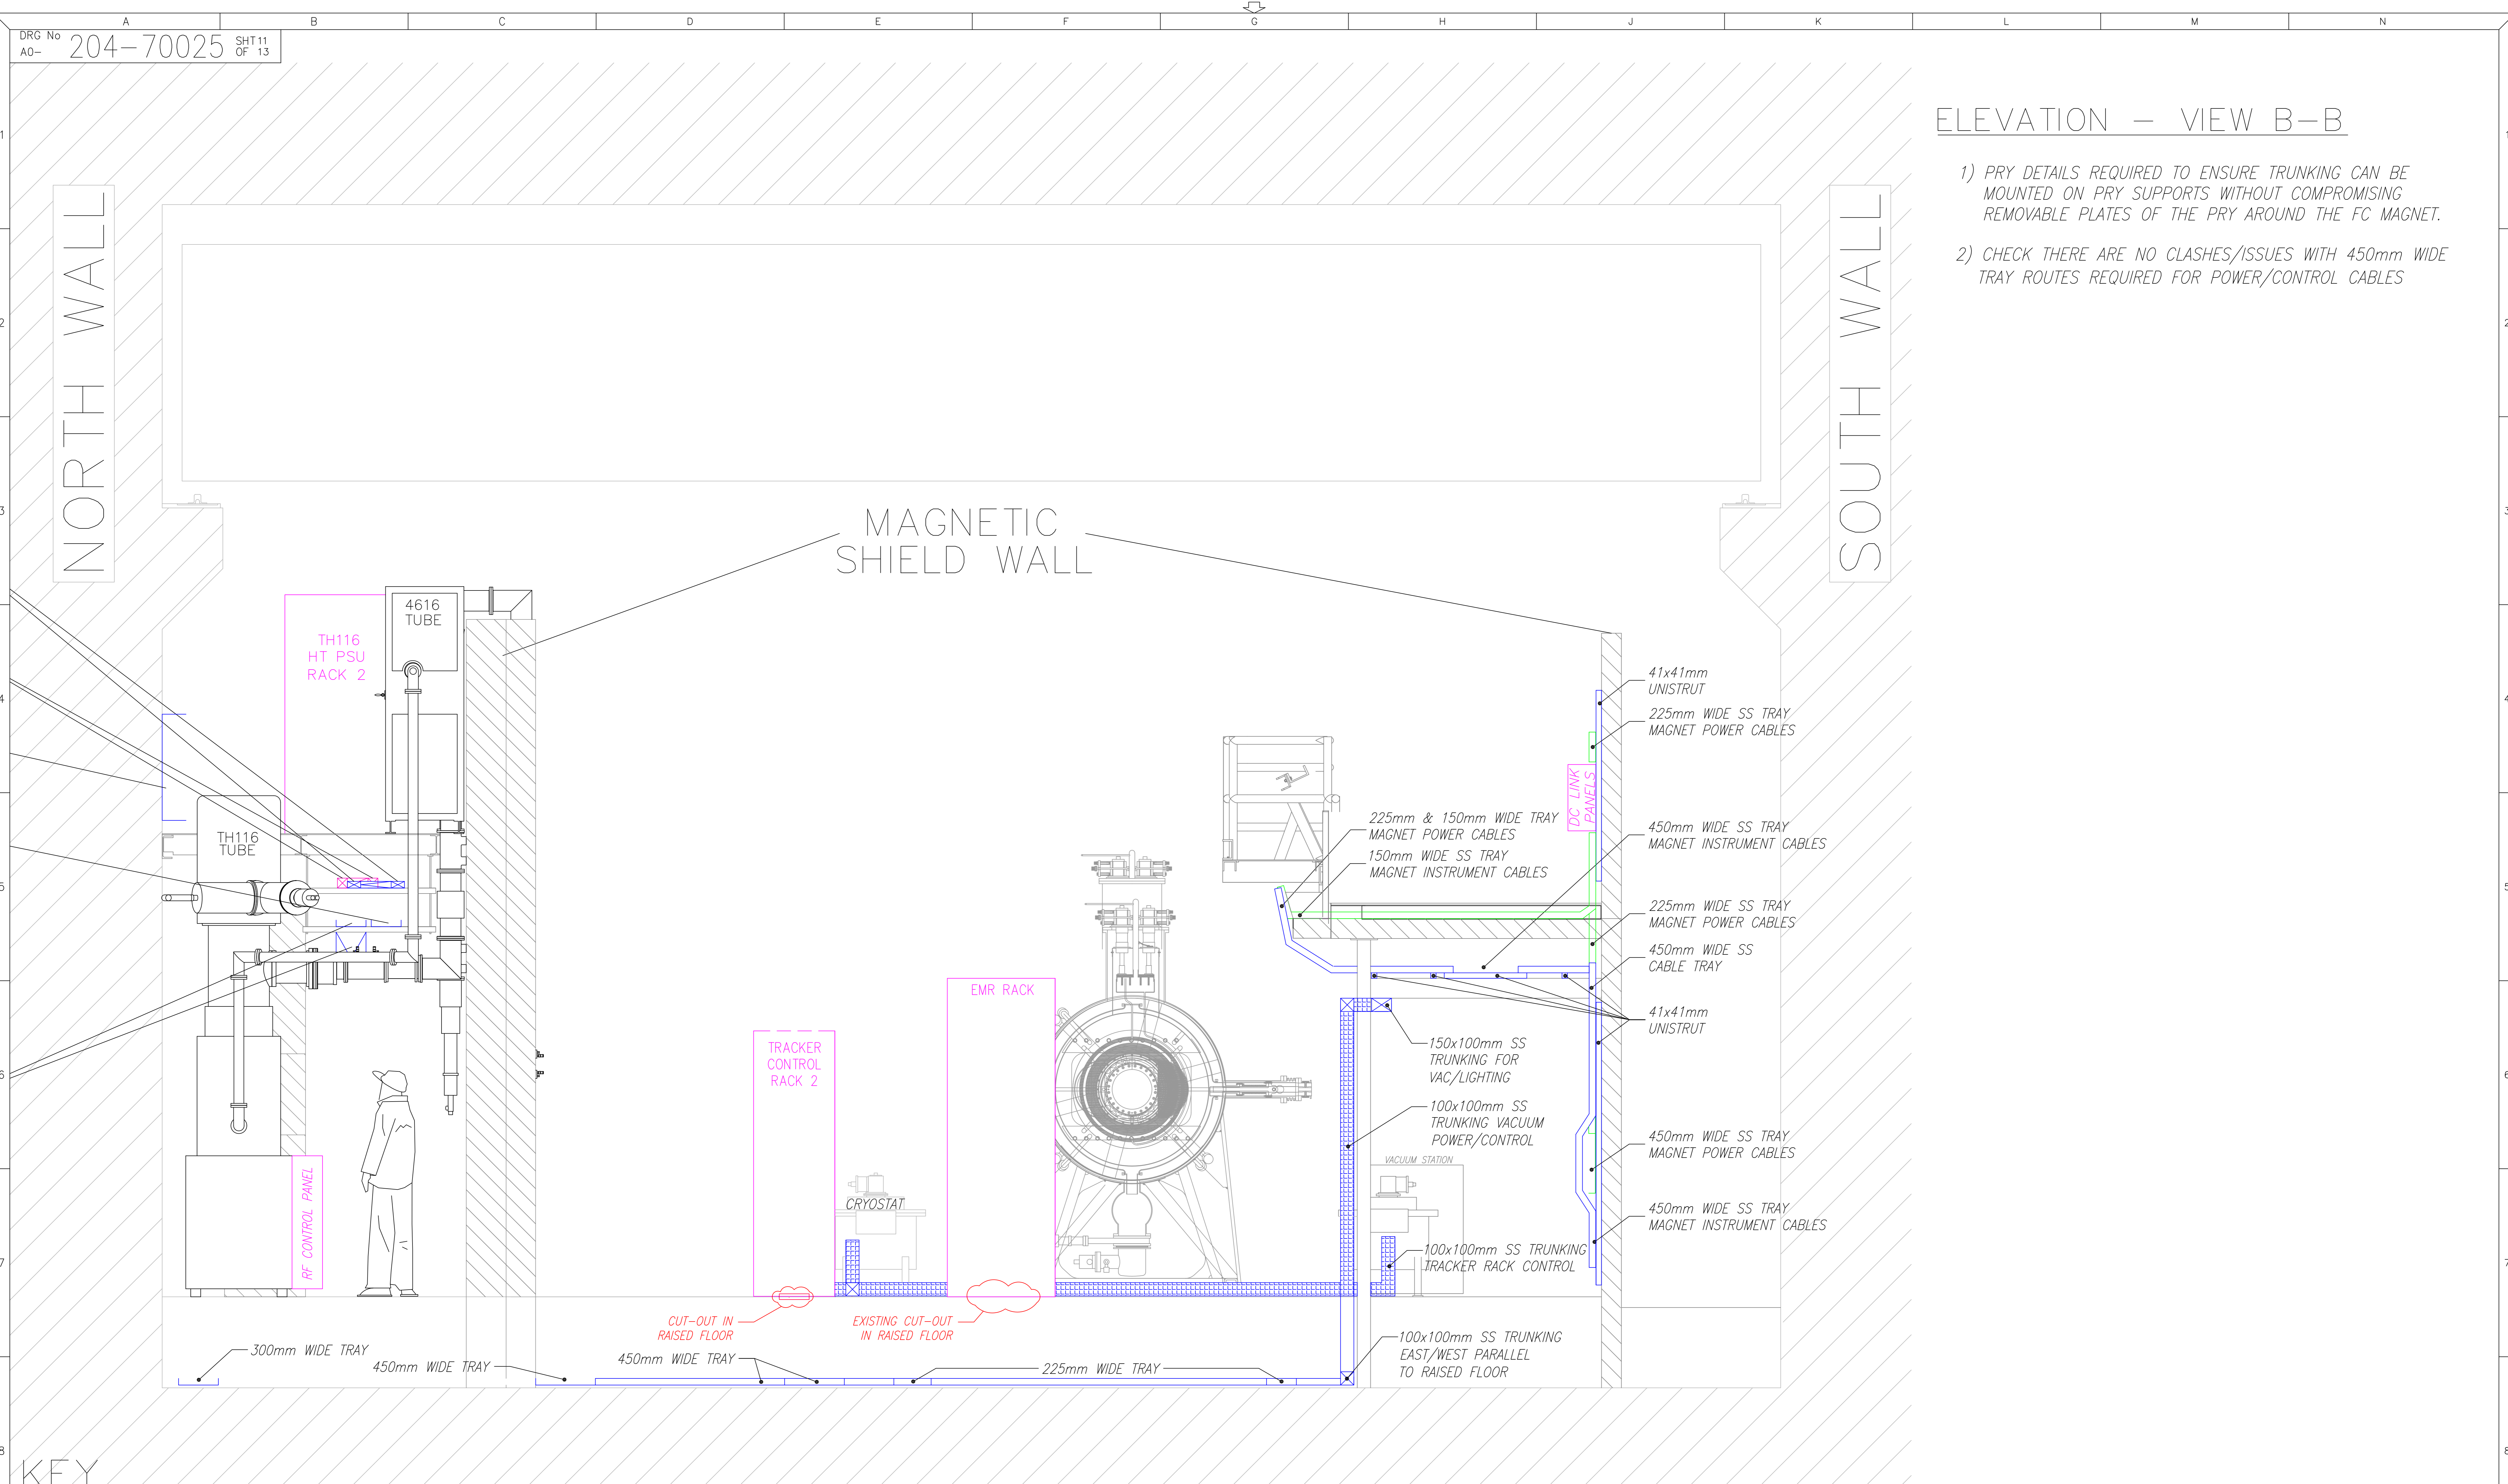

KEY

- TRAY/TRUNKING INSTALLED UNDER RAISED FLOOR
- RAISED FLOOR/FLOOR DUCTS
- ▨ TRUNKING INSTALLED ABOVE RAISED FLOOR
- CONTROL/PSU RACKS
- CUT OUT IN RAISED FLOOR
- PARTIAL RETURN YOKE (PRY)

A	FIRST ISSUE	DRN JWW DATE AUG 14 APPD	INFRASTRUCTURE MEETING UPDATE: 450 WIDE TRAY MOVED. SUMITOMO COMP'S TRUNKING ROUTES UPDATE.	C	DRN JWW DATE OCT 2014 APPD	VISUAL INSPECTION OF MICE HALL: 450 WIDE TRAY MOVED. SUMITOMO COMP'S TRUNKING ROUTES UPDATE.	D	DRN JWW DATE NOV 2014 APPD	TRAY/TRUNKING FLOOR CUT-OUTS AND PANEL LOCATIONS AS INSTALLED	E	DRN JWW DATE NOV 2014 APPD	COMPRESSOR HOSE ROUTES UPDATED DUE TO REPOSITIONING OF COMPRESSORS. TRENCH TRAY SIZE CHANGED.
---	-------------	--------------------------------	---	---	----------------------------------	--	---	----------------------------------	---	---	----------------------------------	---

SCALE 0

ALL DIMENSIONS IN MILLIMETERS UNLESS OTHERWISE STATED
SCIENCE AND TECHNOLOGY FACILITIES COUNCIL
DARESBUURY LABORATORY
CHESHIRE

DRN	JWW	DATE MAY 2014	
CKD		TITLE	
DATE		MICE HALL EQUIPMENT, TRAY & TRUNKING POSITION LAYOUTS	
CERT		DATE	
APPD		DRG No 204-70025 SHT 11 OF 13	
DATE		CAD PART No 204-70025_11	
DRAWING LIST: - 204/70000			
CONTRACTORS COMPANY			
CONTRACTORS DRG No			

ORIGINAL FRAME SIZE 1140mm X 790mm